REGISTERED SURVEYOR MADISON THE TOWNS Janing Inspector: ACYM Permit: -11710

ROC		Ö	*	2	ယ	•	٠	5
ROCK OUTCROPPINGS	REVISIONS	DATE						
PINGS	<i>•</i>	48						
))	DAO		ORAMN BY	2X.0		CREW
Çironanı	A.S.V				A YAB		J. J. Art	1,00
ISOLATION RA	DI AN PREPARED RY		JUNESAF	PAINESVILLE OHIO	SCALE 1" = 3	DATE	(0/54/05	APP'D.
ISOLATION RADIUS FROM WELL	RD RY		BABCOCK & JONES & ASSOCIATES, INC	OHIO	PHONE NO.	DRAWING NO.		14 - R1-52

WATER MAIN SIZE, LOCATION
SAN, SEWER SIZE % GR. LOC.
SAN, MH. CAST. ELEV. INV. ELEV.
SAN, CONN. SIZE, LOC. DEPTH
STORM SEWER SIZE % GR. LOC.
STORM MH. CAST ELEV. INV. ELEV.
FAVT TYPE GRADE CURBS
GASLINE LOC. SIZE PRESSURE
SEPTIC TANK LOCATION & DUPLICATION AREA

THIS PLAT WAS PREPARED BY ME, AND IS CORRECT
TO THE BEST OF MY KNOWLEDGE AND BELIEF.

NAME SURVEYOR REGISTRATION NO.

CHECK LIST

DESIGN CERTIFICATION

LOCATIONS AS SHOWN OF ADJACENT WELLS AND SEPTIC TANKS OBTAINED FROM LAKE COUNTY HEALTH DEPARTMENT ALL BOUNDARY DATA SHOWN WAS OBTAINED FROM (DEEDS, RECORDED SUBDIVISION PLAT OR OTHER PUBLIC RECORDS)

REMARKS

רתקתאט	TI NO
SANITARY MANHOLE	WATER VALVE (GAS)
STORM MANHOLE	WATER METER (GAS)
NLET OR CATCH BASIN	AS BUILT ELEVATION
HYDRANT	<i></i>
EXISTING CONTOURS	INDICATES
PROPOSED CONTOURS	C DIRECTION OF
EXIST. ELEV 100.0 - PROP. ELEV.	V SURFACE DRAINAGE

SUBLOT NO. PERM. PARCEL NO. STREET

VOL UME 537 TRACT PAGE


COUNTY, OHIO

707:

rading Plan Approved shown and/or noted OMAS P. GILLES, P.E. ake County Engineer

Date 11.4.81

SITE PLAN

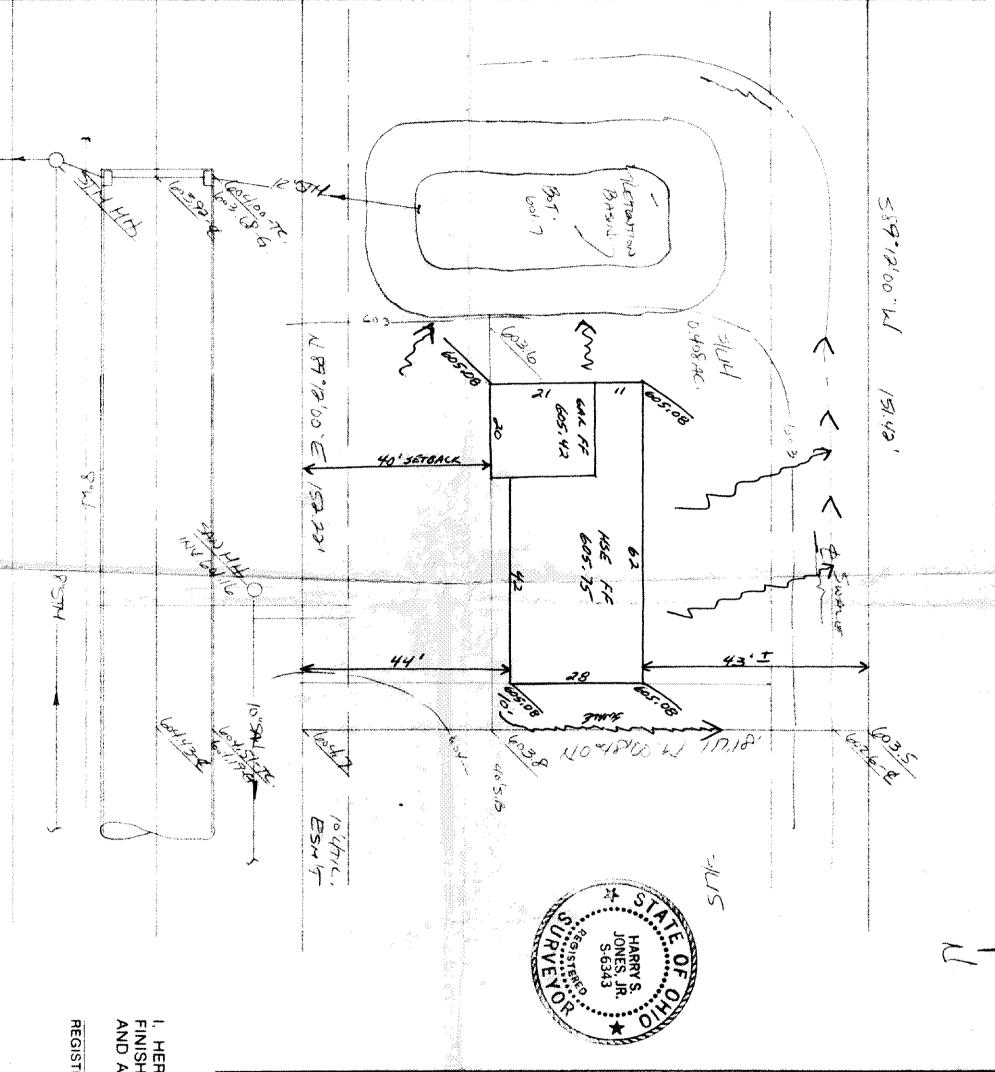

50°24'30'E 117.18'